

LABOR AND MATERIALS

1	Copper Lead	} Connection ^{3/4}	\$
1	Curb		\$
		} Cock Valve } ^{3/4} in.	\$
			T.S. & V.
1	Service box Old returned	} Short 3 1/2 x 4 1/2 } Long 4 1/2 x 5 1/2 }	\$
27	Ft. ^{3/4} in.		} Copper C.I. } Pipe at
	Nipples	in. at	
	Bushings	to in. at	\$
	Red'g Inc'g } Coupl'gs	to in. at	\$
	Union	in. at	\$
	Meter	in. at	\$
	Compound Joints	at	\$
	Maintenance Foreman		\$
	Hrs. Water Maint. Man—1	at	\$
	Hrs. Water Maint. Man—2	at	\$
	Hrs. Garage Foreman	at	\$
	Hrs. Labor	at	\$
	Hrs. Compressor	at	\$
	Trucking		\$
	Pav't Patch		\$
			\$
			\$
			\$
			\$

CHERRY


St. Pt. Ave. No. 63

Name of Owner

BUCKLEY

Labor and Mat'l. Report

MAY 1941

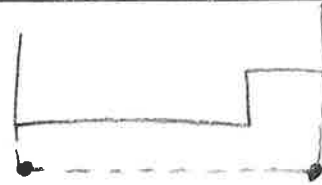

20'3" 19'4" ● Curb Box

4" Main

Elev. of Main at tap 6'

Gate at ●

● Gate at

● Curb Box