


LABOR AND MATERIALS

1	Copper Lead	Connection	3/4"	\$
1	Curb	Cock Valve T.S. & V.	3/4 in.	\$
1	Service box Old returned	Short 3 1/2 x 4 1/2 Long 4 1/2 x 5 1/2		\$
	Ft. 3/4 in.	Copper C.I. C.I.	Pipe at	\$
	Nipples	in. at		\$
1	Bushings	3/4" to 1/2 in.	at	\$
	Red'g Inc'g	Coupl'gs	to in. at	\$
	Union	in. at		\$
	Meter	in. at		\$
	Compound Joints	at		\$
	Maintenance Foreman			\$
	Hrs. Water Maint. Man-1	at		\$
	Hrs. Water Maint. Man-2	at		\$
	Hrs. Garage Foreman	at		\$
	Hrs. Labor	at		\$
	Hrs. Compressor	at		\$
	Trucking			\$
	Pav't Patch			\$
				\$
				\$
St. CHERRY
~~Pl.~~ Ave. No. 73
 Name of Owner
 TAX ID # 303.13-17-17

Labor and Mat'l. Report NOV 19 26

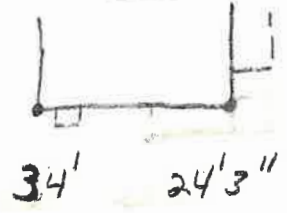

● Curb Box

4" Main Elev. of Main at tap 6'

Gate at ● ● Gate at

● Curb Box