

LABOR AND MATERIALS


1	Copper Lead	Connection	3/4"	\$	_____
1	Curb	Cock Valve T.S. & V.	3/4 in.	\$	_____
1	Service box Old returned	Short 3 1/2 x 4 1/2 Long 4 1/2 x 5 1/2		\$	_____
22	Ft. 3/4 in.	Copper C.I. C.I.	Pipe at	\$	_____
	Nipples	in. at		\$	_____
	Bushings	to in. at		\$	_____
1	Red'd Inc'y	Coupl'gs	3/4 to BRASS in.	\$	_____
	Union	in. at		\$	_____
	Meter	in. at		\$	_____
				\$	_____
	Compound Joints	at		\$	_____
	Maintenance Foreman			\$	_____
	Hrs. Water Maint. Man	—1 at		\$	_____
	Hrs. Water Maint. Man	—2 at		\$	_____
	Hrs. Garage Foreman	at		\$	_____
	Hrs. Labor	at		\$	_____
	Hrs. Compressor	at		\$	_____
				\$	_____
	Trucking			\$	_____
	Pav't Patch			\$	_____
				\$	_____
				\$	_____
CHERRY

St. PR. Ave. No. 75

Name of Owner _____

Labor and Mat'l. Report JULY 1927

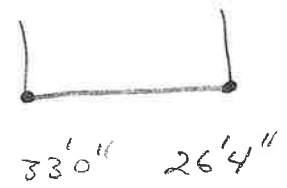

● Curb Box

4" Main

Elev. of Main at tap 6'

Gate at ● ● Gate at

● Curb Box