

LABOR AND MATERIALS

| | | | | | |
|-----------------------------------------------------------------|-----------------------------|-------------------------------------------------------------|-----|---------|-----------|
| 1 | Copper Lead | } Connection | 3/4 | | \$ 2.80 |
| 1 | Curb | { Clock Valve T.S. & V. | 3/4 | in. | \$ 3.60 |
| 1 | Service box Old returned | { Short 3 1/2 X 4 1/2 Long 4 1/2 X 5 1/2 Buffer Rdway | | | \$ 5.80 |
| 10 Ft. | 3/4 in. | { Copper Galv. Iron Cast Iron | 35 | Pipe at | \$ 3.50 |
| Nipples in. at \$ | | | | | |
| Bushings to in. at \$ | | | | | |
| Red'g Inc'g } Couplings to in. at \$ | | | | | |
| Union in. at \$ | | | | | |
| Meter in. at \$ | | | | | |
| Lead Joints at \$ | | | | | |
| Compound Joints at \$ | | | | | |
| Hrs. Foreman at \$ | | | | | |
| 1 | Hrs. Chauffeur at | 91 | | | \$ 91 |
| 9 | Hrs. Tapper at | 91 | | | \$ 819 |
| Hrs. Labor at \$ | | | | | |
| 16 | Hrs. Labor at | 80 | | | \$ 138.00 |
| 1 | Hrs. Compressor at | 97 1/2 | | | \$ 89 |
| Compensation Ins. \$ | | | | | |
| Trucking \$ | | | | | |
| Builders Use of Water \$ | | | | | |
| <i>Top 4 Meters</i> | | | | | |
| \$ 47.26 | | | | | |


147-47

Cherry

St. _____
Pl. _____
Ave. No. 9

Name of Owner Papa

Labor and Mat'l. Report Oct 24 1947

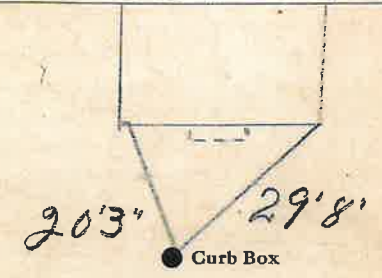

4 Main Elev. of Main at tap 6

Gate at ● ● Gate at

● Curb Box