

LABOR AND MATERIALS

Copper	} Connection	_____	\$	_____	
Lead					
Curb	} Cock Valve T. S. & V.	_____ in.	\$	_____	
Service box		} Short 3 1/2 x 4 1/2			
Old returned			Long 4 1/2 x 5 1/2		
		Buff or Rdway	\$	_____	
30 Ft. / "	} Copper	} Pipe at			
			Gal.	\$	_____
			Cast	\$	_____
Nipples	in. at	_____	\$	_____	
Bushings	to in. at	_____	\$	_____	
Red'g	} Coupl'gs	to in. at			
Inc'g			\$	_____	
Union	in. at	_____	\$	_____	
Meter	in. at	_____	\$	_____	
Lead Joints	at	_____	\$	_____	
Compound Joints	at	_____	\$	_____	
Maintenance Foreman		_____	\$	_____	
Hrs. Water Maint. Man	—1 at	_____	\$	_____	
Hrs. Water Maint. Man	—2 at	_____	\$	_____	
Hrs. Garage Foreman	at	_____	\$	_____	
Hrs. Labor	at	_____	\$	_____	
Hrs. Compressor	at	_____	\$	_____	
Compensation Ins.	at \$ _____ per C	_____	\$	_____	
Trucking		_____	\$	_____	
Pav't Patch		_____	\$	_____	
		_____	\$	_____	
		_____	\$	_____	
O'head		_____	\$	_____	


Shut off on main

*Sept on water main
looking from curb box*

St. PL. Ave. No. 7
CHESTER

Name of Owner _____

Labor and Mat'l. Report. July 12 19 83

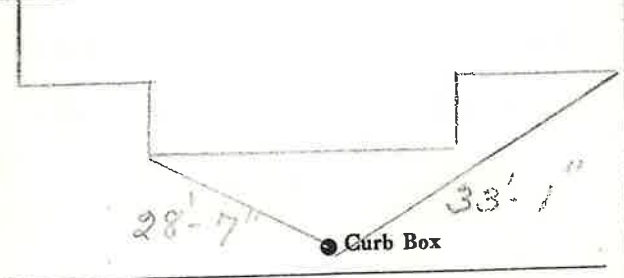

10" Main Elev. of Main at tap _____
Gate at • Gate at •

renewed Tap • Curb Box