


LABOR AND MATERIALS

..... Copper } Connection.....	\$
..... Lead }		
..... Curb { Clock Valve } in.	\$
..... T. S. & V. }		
..... Service box } Short 3 1/2 X 4 1/2 }	\$
..... Old returned } Long 4 1/2 X 5 1/2 }		
..... Buff or Rdway }		
..... Ft. in. } Copper } Pipe at	\$
..... Galv. Iron }		
..... Cast Iron }		
..... Nipples in. at	\$
..... Bushings to	\$
..... Red'g } Couplings..... to in. at	\$
..... Inc'g }		
..... Union in. at	\$
..... Meter..... in. at	\$
..... Lead Joints at		\$
..... Compound Joints at		\$
..... Hrs. Foreman at		\$
..... Hrs. Chauffeur at		\$
..... Hrs. Tapper at		\$
..... Hrs. Labor at		\$
..... Hrs. Labor at		\$
..... Hrs. Compressor at		\$
..... Compensation Ins.		\$
..... Trucking		\$
..... Builders Use of Water.		\$
.....		\$
.....		\$
St.
 Pl.
 Ave. No. 17

Name of Owner _____

Labor and Mat'l. Report Dec 5 1945

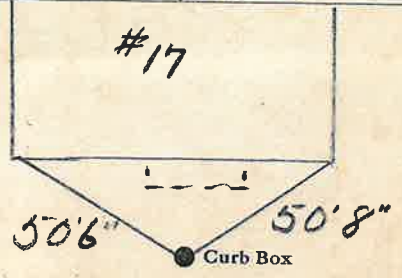

..... Main Elev. of

Main at tap.....

Gate at ● ● Gate at

● Curb Box