


LABOR AND MATERIALS

1	Copper Lead	} Connection $\frac{3}{4}$	\$
1	Curb		\$
		} Cock Valve T.S. & V. } $\frac{3}{4}$ in.	\$
1	Service box Old returned		} Short $3\frac{1}{2} \times 4\frac{1}{2}$ Long $4\frac{1}{2} \times 5\frac{1}{2}$ }
12	Ft. $\frac{3}{4}$ "	} Copper C.I. C.I. }	
	Nipples		in. at \$
	Bushings	to in. at \$	
	Red'g Inc'g	} Coupl'gs to in. at \$	
	Union		in. at \$
	Meter	in. at \$	
	Compound Joints	at \$	
	Maintenance Foreman	\$	
	Hrs. Water Maint. Man—1	at \$	
	Hrs. Water Maint. Man—2	at \$	
	Hrs. Garage Foreman	at \$	
	Hrs. Labor—	at \$	
	Hrs. Compressor	at \$	
	Trucking	\$	
	Pav't Patch	\$	
		\$	
		\$	
		\$	
		\$	

St. CHESTER
~~Pl.~~
 Ave. No. 20

Name of Owner
GINSBURG

Labor and Mat'l. Report NOV 1937

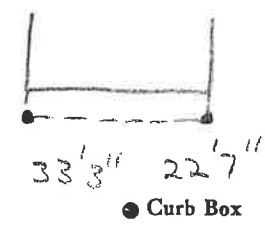

10" Main IRON MAIN Elev. of Main at tap 6'

Gate at ● Gate at ●

● Curb Box