


LABOR AND MATERIALS

1	Copper Lead	Connection	3/4	\$	
1	Curb	Cock Valve	1 in.	\$	
		T. S. & V.			
1	Service box	Short	3 1/2 x 4 1/2		
	Old returned	Long	4 1/2 x 5 1/2	\$	
10	Ft.	1 in.	Copper G. I. Pipe	\$	
	Nipples	in.	at	\$	
1	Bushings	to	1 in.	at	\$
	Red'g Inc'g	Coupl'gs	to in.	at	\$
	Union	in.	at	\$	
	Meter	in.	at	\$	
	Compound Joints	at		\$	
	Maintenance Foreman			\$	
	Hrs. Water Maint. Man-1	at		\$	
	Hrs. Water Maint. Man-2	at		\$	
	Hrs. Garage Foreman	at		\$	
	Hrs. Labor	at		\$	
	Hrs. Compressor	at		\$	
	Trucking			\$	
	Pav't Patch			\$	
				\$	
				\$	
St. CHESTER
~~Pl.~~
 Ave. No. 28
 Name of Owner
 TAX ID # 302.16-11-45

Labor and Mat'l. Report APR. 19 25

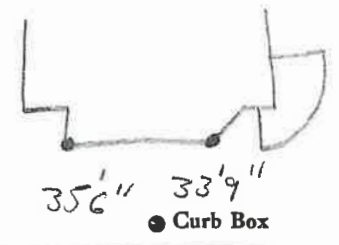

10" Main Elev. of Main at tap 4 1/2'
 Gate at ● Gate at

● Curb Box