

LABOR AND MATERIALS


1	Copper Lead	Connection ^{3/4"}		\$ _____
1	Curb	Cock Valve T.S. & V. } ^{3/4 in.}		\$ _____
1	Service box Old returned	Short ^{3 1/2 x 4 1/2} Long ^{4 1/2 x 5 1/2}		\$ _____
11	Ft.	^{3/4 in.} { Copper C.I. C.I. } Pipe at		\$ _____
	Nipples	in. at		\$ _____
1	Bushings	^{3/4} to ^{1/2} in. at		\$ _____
	Red'g Inc'g } Coupl'gs	to in. at		\$ _____
	Union	in. at		\$ _____
	Meter	in. at		\$ _____
	Compound Joints	at		\$ _____
	Maintenance Foreman			\$ _____
	Hrs. Water Maint. Man-1	at		\$ _____
	Hrs. Water Maint. Man-2	at		\$ _____
	Hrs. Garage Foreman	at		\$ _____
	Hrs. Labor	at		\$ _____
	Hrs. Compressor	at		\$ _____
	Trucking			\$ _____
	Pav't Patch			\$ _____
				\$ _____
				\$ _____
St. 11
Ave. No. 8

CHESTER

Name of Owner _____

Labor and Mat'l. Report JULY 1928

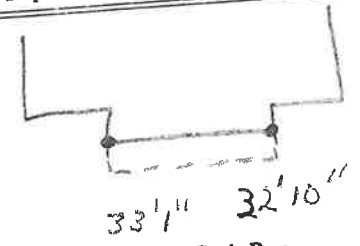

10" Main

Elev. of Main at tap 6'

Gate at ● ● Gate at

● Curb Box