

LABOR AND MATERIALS

1	Copper	} Connection	1"	\$	
	Lead				
1	Curb	} Cock Valve T.S. & V.	1" in.	\$	
1	Service box	} Short 3 1/2 x 4 1/2	}	\$	
	Old returned				Long 4 1/2 x 5 1/2
31	Ft.	} Copper G. I. Cast	1" in.	} Pipe at	\$
	Nipples	in.	at	\$	
	Bushings	to	in.	at	\$
	Red'g	} Coupl'gs	to	in.	at
	Inc'g				
	Union	in.	at	\$	
	Meter	in.	at	\$	
				\$	
	Compound Joints	at		\$	
	Maintenance Foreman			\$	
	Hrs. Water Maint. Man-1	at		\$	
	Hrs. Water Maint. Man-2	at		\$	
	Hrs. Garage Foreman	at		\$	
	Hrs. Labor	at		\$	
	Hrs. Compressor	at		\$	
				\$	
	Trucking			\$	
	Pav't Patch			\$	
				\$	
				\$	
				\$	
				\$	


CHESTER

St. Pl. Ave. No. 37

Name of Owner

Labor and Mat'l. Report

MAY 19 22

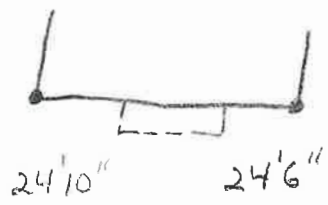

● Curb Box

Main

Elev. of Main at tap

Gate at ●

● Gate at

TAX ID # 302.16-19-7

● Curb Box

GATE VALVE WITH ROD