

LABOR AND MATERIALS

1	Copper Lead	Connection	3/4	\$
1	Curb	Cock Valve F.S. & V.	3/4 in.	\$
1	Service box Old returned	Short 3 1/2 x 4 1/2 Long 4 1/2 x 5 1/2		\$
11	Ft.	Copper C.I. C.I.	3/4 in. } Pipe at	\$
	Nipples	in. at		\$
1	Bushings	1/2 to 3/4 in. at		\$
	Red'g Inc'g	Coupl'gs to in. at		\$
	Union	in. at		\$
	Meter	in. at		\$
	Compound Joints	at		\$
	Maintenance Foreman			\$
	Hrs. Water Maint. Man-1	at		\$
	Hrs. Water Maint. Man-2	at		\$
	Hrs. Garage Foreman	at		\$
	Hrs. Labor	at		\$
	Hrs. Compressor	at		\$
	Trucking			\$
	Pav't Patch			\$
				\$
				\$
CHESTER


St. ~~Pl.~~ 38
Ave. No.

Name of Owner

TAX ID # 302.16-12-40

Labor and Mat'l. Report

JUNE 19 27

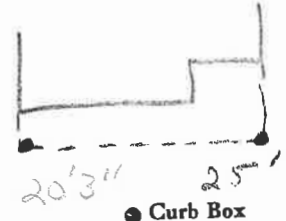

10" Main

Elev. of Main at tap 5'

Gate at ●

● Gate at

● Curb Box