


LABOR AND MATERIALS

1	Copper Lead	{ Connection	3/4"	\$	3.04
1	Curb	{ Cock Valve F.S. & V.	3/4" in.	\$	3.54
1	Service box Old returned	{ Short 3 1/2 x 4 3/8 Long 4 1/2 x 5 1/2 Buff or Rdway		\$	4.70
27'	3/4 in.	{ Copper C.I. C.I.	Pipe at	\$	9.45
	Nipples	in. at		\$	
	Bushings	to in. at		\$	
	Red'g Inc'g	{ Coupl'gs to in. at		\$	
	Union	in. at		\$	
	Meter	in. at		\$	
	Lead Joints at			\$	
	Compound Joints at			\$	
4	Hrs. Water Maint. Man-1 at	1.23	\$	4.92	41.36
16	Hrs. Water Maint. Man-2 at	1.13	\$	18.08	
18	Hrs. Labor at	1.02	\$	18.36	
	Hrs. Labor at		\$		
4	Hrs. Compressor at	1.50	\$	6.00	
	Compensation Ins. at \$ 2.64 per C.		\$	1.10	
	Trucking		\$	1.00	
	Pav't Patch		\$	19.35	
			\$		
			\$		
			\$		
	O'head		\$		

Tap made by Gifford  
Sept 13-1951  
\$ 94.24

St. ~~Rt.~~ Ave. No. 11  
Chester  
Name of Owner (Charles)  
C. Ginsburg

Labor and Mat'l. Report Sept 13 1951

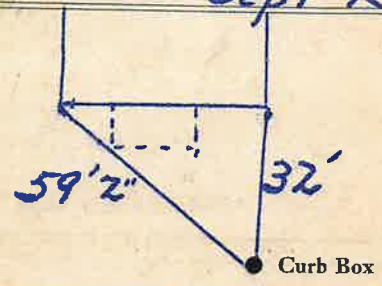

10" Main  
Elev. of Main at tap 5 1/2'

Gate at • Gate at

• Curb Box