


LABOR AND MATERIALS

1 Copper Lead Connection $1\frac{1}{2}$ " \$
 1 Curb Cock } $1\frac{1}{2}$ " oriseal \$
 Valve }
 T.S. & V. }
 1 Service box { Short $3\frac{1}{2}$ x $4\frac{1}{2}$ }
 Old returned { Long $4\frac{1}{2}$ x $5\frac{1}{2}$ } \$
 Buff or Rdway }
 27 Ft. $1\frac{1}{2}$ " in. { Copper } Pipe at \$
 G.I. }
 G.I. }
 Nipples in. at \$
 Bushings to in. at \$
 1 Red-g. Coupl'gs $1\frac{1}{2}$ " to $1\frac{1}{2}$ " in. at \$
 1 Jac'g }
 Union in. at \$
 Meter in. at \$
 Lead Joints at \$
 Compound Joints at \$
 Maintenance Foreman \$
 Hrs. Water Maint. Man-1 at \$
 Hrs. Water Maint. Man-2 at \$
 Hrs. Garage Foreman at \$
 Hrs. Labor at \$
 Hrs. Compressor at \$
 Compensation Ins. at \$ per C \$
 Trucking \$
 Pav't Patch \$
 Tap by G.I. + 50' d + 7' \$
 9-5-62. \$
 O'head \$
 \$

St. Chester
 Pl. 13-15
 Ave. No. _____

Name of Owner Salvation Army

Labor and Mat'l. Report Sept 4 19 62

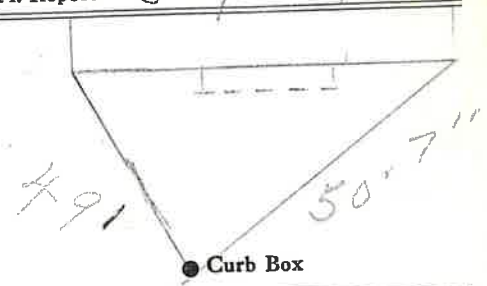

10" C.I. 7' Elev. of Main at tap 6'
 Gate at • Gate at

coupling → 20'
 10" C.I. • Curb Box 10' 21"