

LABOR AND MATERIALS


1	Copper Lead	Connection	3/4	\$
1	Curb	Cock Valve T. S. & V.	1 in.	\$
1	Service box Old returned	Short 3 1/2 x 4 1/2 Long 4 1/2 x 5 1/2		\$
6	Ft. 1 in.	Copper G. I. C.P.	Pipe at	\$
	Nipples	in. at		\$
	Bushings	to in. at		\$
	Red'g Inc'g	Coupl'gs	to in. at	\$
	Union	in. at		\$
	Meter	in. at		\$
	Compound Joints	at		\$
	Maintenance Foreman			\$
	Hrs. Water Maint. Man	1 at		\$
	Hrs. Water Maint. Man	2 at		\$
	Hrs. Garage Foreman	at		\$
	Hrs. Labor	at		\$
	Hrs. Compressor	at		\$
	Trucking			\$
	Pav't Patch			\$
				\$
				\$
CHESTER

St. ~~Pl.~~
Ave. No. 14

Name of Owner
TAX ID # 302.16-11-40

Labor and Mat'l. Report AUG 19 24

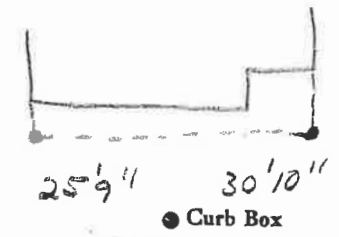

10" Main

Elev. of
Main at tap 4 1/2'

Gate at ● Gate at ●

● Curb Box