



WATER DEPARTMENT

City of Glens Falls, New York

Nov 2 1953

A. M. P. M.

M 3/4" Ran Tap


Tel. Call: 14 Church St

Turn on: St Mary's Church

Shut off:

Leak:

Misc: 16' 23'

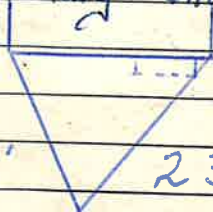

REMARKS: 1-3/4" Corp Stop

1-3/4" Curb Stop

Same Curb box

14'-3/4" K. Copper

6" Main 4 1/2" deep

Tap by Gifford 11-9-53

By: Tripp From: To: