


Labor and Materials

Lead Connection	3	\$ 2.69
Curb Cock	1	\$ 1.76
Service Box (Short 3" x 4") Old returned (Long 4" x 5") Buffalo		\$
5 Ft. 1 in. G. I. Pipe at		\$ 9.8
Nipples.....in. at		\$
Bushings.....to.....in. at		\$
Red'g Coup.....to.....in. at		\$
Inc'g Coup.....to.....in. at		\$
Union.....in. at		\$
Meter.....in. at		\$
Cu. Yds. Br. Stone at		\$
Cu. Yds. Sand at		\$
Bags Cement at		\$
Paving Brick { Mack Red Asphalt } at		\$
2 Hrs. Foreman at		\$ 1.25
8 Hrs. Common Labor at		\$ 3.25
Hrs. Mason at		\$
Hrs.....at		\$
Hrs.....at		\$
Builders' Use of Water		\$
Trucks	at	\$ 1.00
Comp Gas	at	\$ 1.2
	at	\$
	at	\$
Total		\$ 11.01

Labor and Material Report

Sept. 24 1924

15 Church St.

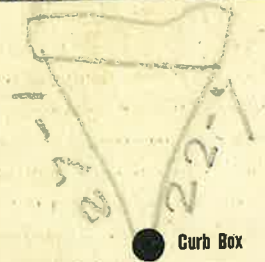

● Curb Box

6 Main

Elev. of Main at tap 4 1/2

Gate at ●

● Gate at

● Curb Box

This Place
Razed.
Shut off at Curb.