

LABOR AND MATERIALS

1 Copper } Connection $\frac{3}{4}$ " \$
 -Lead }
 1 Curb } Cock } $\frac{3}{4}$ " oriseal \$
 } Valve }
 } T.S. & V. }
 1 Service box { Short $3\frac{1}{2}$ x $4\frac{1}{2}$ }
 -Old returned { Long $4\frac{1}{2}$ x $5\frac{1}{2}$ }
 { Buff or Rdway } \$
 28 Ft. $\frac{3}{4}$ in. { Copper } Pipe at \$
 { G.I. }
 { C.I. }
 _____ Nipples _____ in. at \$
 _____ Bushings _____ to _____ in. at \$
 Red'g }
 Inc'g } Coupl'gs _____ to _____ in. at \$
 _____ Union _____ in. at \$
 _____ Meter _____ in. at \$
 _____ Lead Joints at \$
 _____ Compound Joints at \$
 _____ Maintenance Foreman \$
 _____ Hrs. Water Maint. Man—1 at \$
 _____ Hrs. Water Maint. Man—2 at \$
 _____ Hrs. Garage Foreman _____ at \$
 _____ Hrs. Labor _____ at \$
 _____ Hrs. Compressor at \$
 _____ Compensation Ins. at \$ _____ per C \$
 _____ Trucking \$
 Pav't Patch \$
 Tap by Gifford & Co. \$
 11-2-46K \$
 _____ \$
 _____ \$
 _____ O'head _____ \$
 _____ \$


Clayton

St. _____
 Pl. _____
 Ave. No. 12

Name of Owner

Labor and Mat'l. Report

Nov. 2 19 62

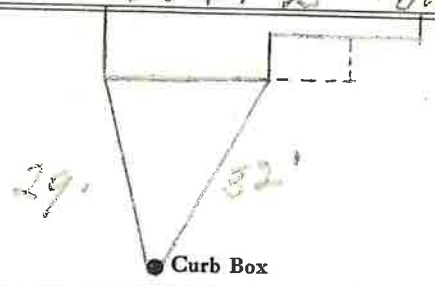

6" City Main

Elev. of Main at tap 6'

Gate at ●

● Gate at

● Curb Box