

LABOR AND MATERIALS

1	Copper	Connection	3/4		\$ 2.94
	Lead				
1	Curb	Cock Valve	3/4	in.	\$ 3.71
		T. S. & V.			
1	Service box	Short 3/4 X 4 1/2			
	Old returned	Long 4 1/2 X 5 1/2			
		Buff or Rdway			\$ 5.90
19	Ft.	Curb	3/4	in.	
		Copper			
		G.I.			
		Pipe at	30		\$ 5.70
	Nipples	in. at			\$
	Bushings	to in. at			\$
	Red'g				
	Inc'g	Coupl'gs to in. at			\$
	Union	in. at			\$
	Meter	in. at			\$
	Lead Joints	at			\$
	Compound Joints	at			\$
	Hrs. Water Maint. Man-1	at			\$
5	Hrs. Water Maint. Man-2	at	1.01		\$ 5.05
17	Hrs. Labor	at	80		\$ 9.60
	Hrs. Labor	at			\$
	Hrs. Compressor	at			\$
	Compensation Ins. at \$	per C.	32		\$
	Trucking		1.00		\$
	Pav't Patch	Before paving			\$
	Top by M. A. S. M. S. K.				\$
	O'head				\$
					\$ 34.25

99

St.
Pl.
Ave. No. 3


Clinton Ave

Name of Owner

Catherine O'Brien

Labor and Mat'l. Report

June 28 19 *48*

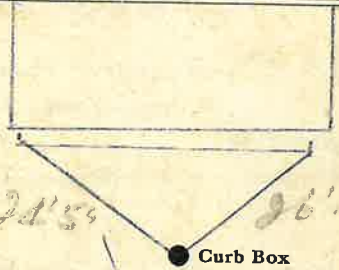

4 Gal
Main

Elev. of
Main at tap 5

Gate at ●

● Gate at

● Curb Box

LSM-5C 5 13-48

To be Billed

