


LABOR AND MATERIALS

1	Copper Lead	Connection	3/4	\$
1	Curb	Cock Valve T. S. & V.	3/4 in.	\$
1	Service box Old returned	Short 3 1/2 x 4 1/2 Long 4 1/2 x 5 1/2		\$
17	Ft.	3/4 in. Copper <del>Cat.</del> <del>Cat.</del>	Pipe at	\$
	Nipples	in. at		\$
	Bushings	to in. at		\$
	Red'g Inc'g	Coupl'gs to in. at		\$
	Union	in. at		\$
	Meter	in. at		\$
	Compound Joints	at		\$
	Maintenance Foreman			\$
	Hrs. Water Maint. Man-1	at		\$
	Hrs. Water Maint. Man-2	at		\$
	Hrs. Garage Foreman	at		\$
	Hrs. Labor	at		\$
	Hrs. Compressor	at		\$
	Trucking			\$
	Pav't Patch			\$
				\$
				\$
CLINTON St. Ave. No. 5

Name of Owner

Labor and Mat'l. Report JUNE 1933

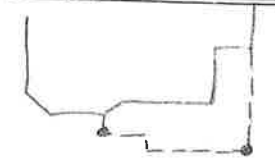

23'9" 31'10"  
● Curb Box

4" Main (GALV.) Elev. of Main at tap 4 1/2'  
Gate at ● ● Gate at

● Curb Box

OLD TAP SHUT OFF AT MAIN