

LABOR AND MATERIALS


1	Copper	}	Connection	3/4"		\$
	Lead					
1	Curb		Cock Valve	3/4 in.		\$
			T.S. & V.			
1	Service box		Short 3 1/2 x 4 1/2			\$
	Old returned		Long 4 1/2 x 5 1/2			
8	Ft.		Copper			\$
	3/4 in.		8 ft.			
			Pipe at			\$
	Nipples		in.			\$
	Bushings		to			\$
	Red'g		Inc'g			\$
			Coupl'gs			\$
	Union		in.			\$
	Meter		in.			\$
	Compound Joints		at			\$
	Maintenance Foreman					\$
	Hrs. Water Maint. Man-1		at			\$
	Hrs. Water Maint. Man-2		at			\$
	Hrs. Garage Foreman		at			\$
	Hrs. Labor		at			\$
	Hrs. Compressor		at			\$
	Trucking					\$
	Pav't Patch					\$
						\$
						\$
COOLIDGE

St. _____
 Pl. _____
 Ave. No. 1

Name of Owner _____

Labor and Mat'l. Report MAY 19 30

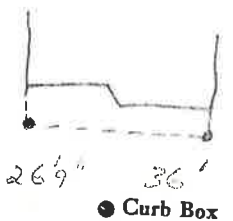

6" Main Elev. of Main at tap 4'

Gate at ● ● Gate at

● Curb Box