

LABOR AND MATERIALS

	Copper	Connection	$\frac{3}{4}$		\$	
	Lead					
	Curb	Cock Valve	$\frac{3}{4}$ in.		\$	
		T-S. & V.				
	Service box	Short $3\frac{1}{2} \times 4\frac{1}{2}$				
	Old returned	Long $4\frac{1}{2} \times 5\frac{1}{2}$			\$	
31	Ft.	$\frac{3}{4}$ in.		Copper	Pipe at	\$
				G.I.		
				C.I.		
	Nipples	in. at			\$	
	Bushings	to in. at			\$	
	Red'g					
	Inc'g	Coupl'gs to in. at			\$	
	Union	in. at			\$	
	Meter	in. at			\$	
					\$	
	Compound Joints	at			\$	
	Maintenance Foreman				\$	
	Hrs. Water Maint. Man	1 at			\$	
	Hrs. Water Maint. Man	2 at			\$	
	Hrs. Garage Foreman	at			\$	
	Hrs. Labor	at			\$	
	Hrs. Compressor	at			\$	
					\$	
	Trucking				\$	
	Pav't Patch				\$	
					\$	
					\$	
					\$	
					\$	

St. _____
Pl. _____
Ave. No. 10


COOLIDGE

Name of Owner

MRS. CHAS. DOOLITTLE

Labor and Mat'l. Report

JULY 14 1937

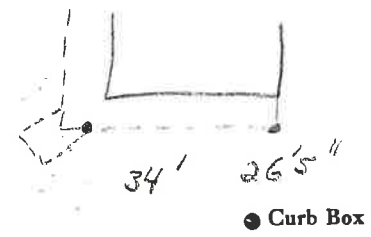

6" Main

Elev. of Main at tap 5'

Gate at ●

● Gate at

● Curb Box

OLD SHUT OFF