


LABOR AND MATERIALS

| | | | |
|----|-------------------------|---------------------------------------|----|
| 1 | Copper | Connection | \$ |
| 1 | Lead | | \$ |
| 1 | Curb | Cock Valve T.S. & V. } in. | \$ |
| 1 | Service box | Short $3\frac{1}{2}$ x $4\frac{1}{2}$ | \$ |
| | Old returned | Long $4\frac{1}{2}$ x $5\frac{1}{2}$ | \$ |
| 32 | Ft. $\frac{3}{4}$ in. | C.I.P. } Pipe at | \$ |
| | | C.I.P. | |
| | Nipples | in. at | \$ |
| | Bushings | to in. at | \$ |
| | Red'g | | \$ |
| | Inc'g | Coupl'gs to in. at | \$ |
| | Union | in. at | \$ |
| | Meter | in. at | \$ |
| | | | \$ |
| | Compound Joints | at | \$ |
| | Maintenance Foreman | | \$ |
| | Hrs. Water Maint. Man-1 | at | \$ |
| | Hrs. Water Maint. Man-2 | at | \$ |
| | Hrs. Garage Foreman | at | \$ |
| | Hrs. Labor- | at | \$ |
| | Hrs. Compressor | at | \$ |
| | | | \$ |
| | Trucking | | \$ |
| | Pav't Patch | | \$ |
| | | | \$ |
| | | | \$ |
St. COOLIDGE
 Pl. 12
 Ave. No. 12
 Name of Owner _____
 TAX ID # 302.15-12-11

Labor and Mat'l. Report JAN. 2 1929

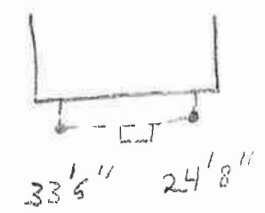

● Curb Box

6" Main Elev. of Main at tap 4 1/2'
 Gate at ● Gate at ●

● Curb Box

OLD TAP TO BE DUG UP