


LABOR AND MATERIALS

1	Copper	} Connection	3/4	\$
	Lead			
1	Curb	} Cock Valve T.S.&V.	3/4 in.	\$
	Service box	} Short 3 1/2 x 4 1/2		\$
	Old returned			
33	Ft.	} Copper G.I. G.I.	3/4 in.	\$
	Nipples	in. at		\$
	Bushings	to in. at		\$
	Red'g Inc'g	} Coupl'gs	to in. at	\$
	Union	in. at		\$
	Meter	in. at		\$
	Compound Joints	at		\$
	Maintenance Foreman			\$
	Hrs. Water Maint. Man	1 at		\$
	Hrs. Water Maint. Man	2 at		\$
	Hrs. Garage Foreman	at		\$
	Hrs. Labor	at		\$
	Hrs. Compressor	at		\$
	Trucking			\$
	Pav't Patch			\$
				\$
				\$
				\$
				\$

St. COOLIDGE
 Pl. Ave. No. 14
 Name of Owner L. B. MACFARREN

Labor and Mat'l. Report JULY 1 1937

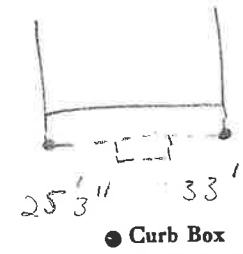

6" Main Elev. of Main at tap 5'
 Gate at ● Gate at ●

● Curb Box

OLD SHUT OFF