

LABOR AND MATERIALS

1	Copper	} Connection $\frac{3}{4}$	\$
Lead			
1	Curb	} $\frac{3}{4}$ in.	\$
	Cock		
	Valve		
	T.S. & V.		
1	Service box	} Short $3\frac{1}{2} \times 4\frac{1}{2}$	\$
Old returned			Long $4\frac{1}{2} \times 5\frac{1}{2}$
13 Ft. $\frac{3}{4}$ in.	Copper	} Pipe at	\$
	C.I.		
	C.I.		
	Nipples	in. at	\$
	Bushings	to in. at	\$
	Red'g	} Coupl'gs to in. at	\$
	Inc'g		
	Union	in. at	\$
	Meter	in. at	\$
	Compound Joints	at	\$
	Maintenance Foreman		\$
	Hrs. Water Maint. Man-1	at	\$
	Hrs. Water Maint. Man-2	at	\$
	Hrs. Garage Foreman	at	\$
	Hrs. Labor	at	\$
	Hrs. Compressor	at	\$
	Trucking		\$
	Pav't Patch		\$
			\$
			\$
COOLIDGE


St. Pt. Ave. No. 15

Name of Owner

EVERETT ROYAL

Labor and Mat'l. Report

JULY 14 1937

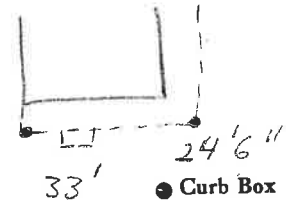

6" Main

Elev. of Main at tap 5'

Gate at •

• Gate at

• Curb Box

OLD SHUT OFF