


LABOR AND MATERIALS

| | | | |
|----|--------------------------|--|--|
| 1 | Copper Lead | } Connection $\frac{3}{4}$ | \$ |
| 1 | Curb | | } Cock Valve T.S. & V. $\frac{3}{4}$ in. |
| 1 | Service box Old returned | } Short $3\frac{1}{2}$ x $4\frac{1}{2}$ Long $4\frac{1}{2}$ x $5\frac{1}{2}$ | |
| 12 | Ft. $\frac{3}{4}$ in. | | } Copper Pipe at |
| | Nipples | in. at | |
| | Bushings | to in. at | \$ |
| | Red'g Inc'g | } Coupl'gs. to in. at | \$ |
| | Union | | in. at |
| | Meter | in. at | \$ |
| | Compound Joints | at | \$ |
| | Maintenance Foreman | | \$ |
| | Hrs. Water Maint. Man | 1 at | \$ |
| | Hrs. Water Maint. Man | 2 at | \$ |
| | Hrs. Garage Foreman | at | \$ |
| | Hrs. Labor | at | \$ |
| | Hrs. Compressor | at | \$ |
| | Trucking | | \$ |
| | Pav't Patch | | \$ |
| | | | \$ |
| | | | \$ |
St. COOLIDGE
 Pt. Ave. No. 17

Name of Owner F.G. EASTLAND

Labor and Mat'l. Report JUNE 1937

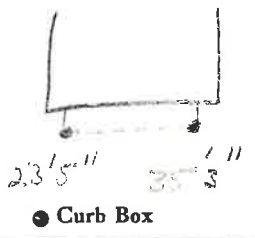

6" Main Elev. of Main at tap 5'

Gate at • Gate at •

• Curb Box

OLD SHUT OFF