

LABOR AND MATERIALS

1	Copper / Lead	Connection	3/4"	\$	2.76
1	Curb	Cock Valve T. S. & V.	3/4 in.	\$	3.49
1	Service box	Short 3 1/2 X 4 1/2		\$	4.74
	Old returned	Long 4 1/2 X 5 1/2		\$	
		Buff or Rdway		\$	
37	Ft.	Copper G.I. Pipe at	3/4 in. 38	\$	12.16
	Nipples	in. at		\$	
	Bushings	to in. at		\$	
	Red'g			\$	
	Inc'g	Coupl'gs to in. at		\$	
	Union	in. at		\$	
	Meter	in. at		\$	
	Lead Joints	at		\$	
	Compound Joints	at		\$	
6	Hrs. Water Maint. Man	1 at	Gar Finan 1.59	\$	9.54
9	Hrs. Water Maint. Man	2 at	2.41	\$	11.16
25	Hrs. Labor	at	1.13	\$	28.25
	Hrs. Labor	at		\$	
2	Hrs. Compressor	at	1.50	\$	8.00
	Compensation Ins.	at \$4.07 per C.		\$	2.16
	Trucking			\$	1.10
	Pav't Patch			\$	16.20
	Tap by Gifford	6-24-53		\$	5.3
	O'head			\$	
				\$	94.46


78.26

6

155
Coolidge St. Ave. No. 2

Name of Owner
Birdsall

Labor and Mat'l. Report June 24 1953

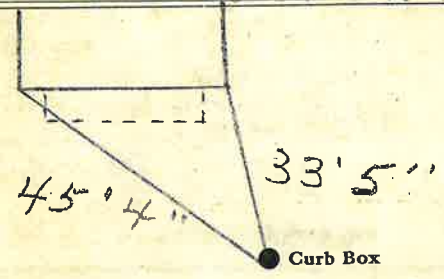

6" Main Elev. of Main at tap 5 1/2'

Gate at ● Gate at ●

● Curb Box