


LABOR AND MATERIALS

| | | | |
|----|-----------------------------|---|--|
| 1 | Copper Lead | } Connection $\frac{3}{4}$ | \$ |
| 1 | Curb | | } Cock Valve T.S. & V. } $\frac{3}{4}$ in. |
| 1 | Service box Old returned | } Short $3\frac{1}{2} \times 4\frac{1}{2}$ Long $4\frac{1}{2} \times 5\frac{1}{2}$ | |
| 32 | Ft. $\frac{3}{4}$ in. | | } Copper C.I. C.I. |
| | Nipples | in. at \$ | |
| | Bushings | to in. at \$ | |
| | Red'g Inc'g | } Coupl'gs to in. at \$ | |
| | Union | | in. at \$ |
| | Meter | in. at \$ | |
| | Compound Joints | at \$ | |
| | Maintenance Foreman | \$ | |
| | Hrs. Water Maint. Man-1 | at \$ | |
| | Hrs. Water Maint. Man-2 | at \$ | |
| | Hrs. Garage Foreman | at \$ | |
| | Hrs. Labor | at \$ | |
| | Hrs. Compressor | at \$ | |
| | Trucking | \$ | |
| | Pav't Patch | \$ | |
| | | \$ | |
| | | \$ | |
ST. Ave. No. 20
 PT.
 COOLIDGE

Name of Owner
 FLORINCE B SEELYE

Labor and Mat'l. Report JUNE 30 19 37

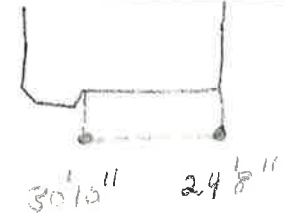

● Curb Box

6" Main Elev. of Main at tap 5'
 Gate at ● Gate at

● Curb Box

OLD SHUT OFF