


LABOR AND MATERIALS

1	Copper Lead	} Connection ^{3/4}	\$	
1	Curb		} Cock Valve T.S. & V. ^{3/4} in.	\$
1	Service box Old returned	} Short 3 1/2 x 4 1/2 } Long 4 1/2 x 5 1/2 }		\$
33	Ft. ^{3/4} in.		} Copper C.I. C.I. } Pipe at	\$
	Nipples	in. at		\$
	Bushings	to in. at	\$	
	Red'g Inc'g	} Coupl'gs	to in. at	\$
	Union			
	Meter	in. at	\$	
	Compound Joints	at	\$	
	Maintenance Foreman		\$	
	Hrs. Water Maint. Man	1 at	\$	
	Hrs. Water Maint. Man	2 at	\$	
	Hrs. Garage Foreman	at	\$	
	Hrs. Labor	at	\$	
	Hrs. Compressor	at	\$	
	Trucking		\$	
	Pav't Patch		\$	
			\$	
			\$	
COOLIDGE ~~St.~~ ~~Pt.~~ Ave. No. 28

Name of Owner
BYRON J JACOBSON

Labor and Mat'l. Report 6-29 1937

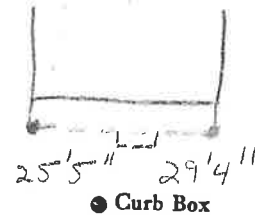

6" Main Elev. of Main at tap 5'
Gate at ● Gate at ●

● Curb Box

OLD SHUT OFF