


~~St.~~  
~~Pl.~~  
COOLIDGE Ave. No. 32

Name of Owner  
MERRETT STAPLES

Labor and Mat'l. Report 6-28 1937

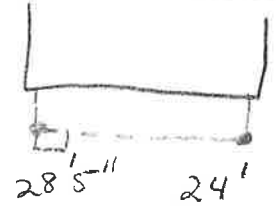

● Curb Box

6" Main Elev. of Main at tap 5'

Gate at ● Gate at

● Curb Box

OLD SHUT OFF

LABOR AND MATERIALS

1	Copper Lead	} Connection $\frac{3}{4}$	\$
1	Curb		} Cock Valve T.S. & V. $\frac{3}{4}$ in.
1	Service box Old returned	} Short $3\frac{1}{2} \times 4\frac{1}{2}$ Long $4\frac{1}{2} \times 5\frac{1}{2}$	
32	Ft. $\frac{3}{4}$ in.		} Copper G.I. G.I.
	Nipples	in. at \$	
	Bushings	to in. at \$	
	Red'g Inc'g	} Coupl'gs	to in. at \$
	Union		
	Meter	in. at \$	
			\$
	Compound Joints	at \$	
	Maintenance Foreman	\$	
	Hrs. Water Maint. Man-1	at \$	
	Hrs. Water Maint. Man-2	at \$	
	Hrs. Garage Foreman	at \$	
	Hrs. Labor	at \$	
	Hrs. Compressor	at \$	
			\$
	Trucking	\$	
	Pav't Patch	\$	
		\$	
		\$	
		\$	
		\$	