

Coolidge


St. Ave. No. 34

Name of Owner

Dr. Batt

Labor and Mat'l. Report

May 26 1955

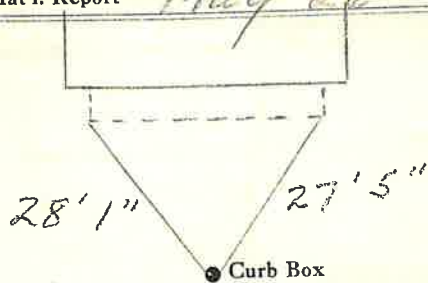

6" Main

Elev. of Main at tap 6'

Gate at •

• Gate at

• Curb Box

LABOR AND MATERIALS

1	Copper Lead	Connection	1"	\$	4.28
1	Curb	Cock Valve T.S. & V.	1 in.	\$	5.25
Same	Service box	Short 3 1/2 x 4 1/2			
	Old returned	Long 4 1/2 x 5 1/2			
		Buff or Rdway		\$	
33	Ft. 1 in.	Copper	Pipe at 56	\$	18.48
		GI			
	Nipples	in. at		\$	
	Bushings	to in. at		\$	
	Red'g				
	Inc'g	Coupl'gs to in. at		\$	
	Union	in. at		\$	
	Meter	in. at		\$	
	Lead Joints	at		\$	
	Compound Joints	at		\$	
8	Maintenance Foreman	1.51		\$	12.08
	Hrs. Water Maint. Man-1	at		\$	
8	Hrs. Water Maint. Man-2	at 1.24		\$	9.92
	Hrs. Garage Foreman	at		\$	
16	Hrs. Labor	at 1.13		\$	18.08
2	Hrs. Compressor	at 1.50		\$	3.00
	Compensation Ins. at \$4.20	per C		\$	1.72
	Trucking			\$	1.50
	Pay't Patch			\$	19.80
	Top by Gifford	5-26-55		\$	
	O'head			\$	
				\$	94.11

34