


Coolidge St. Ave. No. 37

Name of Owner
Graham E. Asson

Labor and Mat'l. Report July 1 1976

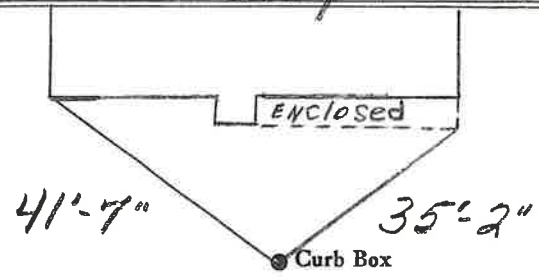

6" Main Elev. of Main at tap 5'

Gate at • Gate at
12' to MAIN

1" COPPER • Curb Box

LABOR AND MATERIALS

1	Copper Lead	Connection	3/4"	\$
1	Curb	Cock Valve T.S. & V.	1 in. Orises #1	\$
1	Service box Old returned	{ Short 3 1/2 x 4 1/2 Long 4 1/2 x 5 1/2 Buff or Rdway		\$
12	Ft. 1 in.	{ Copper G.I. C.I.	Pipe at	\$
	Nipples	in. at		\$
	Bushings	to in. at		\$
	Red'g Inc'g	Coupl'gs to in. at		\$
	Union	in. at		\$
	Meter	in. at		\$
1	Lead Joints at	1" BYPASS ELBOW		\$
	Compound Joints at			\$
	Maintenance Foreman			\$
	Hrs. Water Maint. Man-1 at			\$
	Hrs. Water Maint. Man-2 at			\$
	Hrs. Garage Foreman at			\$
	Hrs. Labor— at			\$
	Hrs. Compressor at			\$
	Compensation Ins. at \$	per C		\$
	Trucking			\$
	Pav't Patch			\$
	Tap By Purvis & Co			\$
	July-1-1976			\$
	O'head			\$
				\$

37