


COOLIDGE ~~St.~~ Ave. No. 49
~~Pl.~~

Name of Owner
GELMAN

Labor and Mat'l. Report 10-19 1923

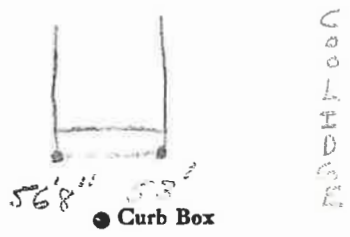

16" Main Elev. of Main at tap 4'
KENSINGTON RD.

Gate at ● Gate at ●

TAX ID # 302.15-6-7

MUELLER CURB ● Curb Box
 BOX IN SWK - TO TURN OFF -
 5-6 TURNS

LSM-5C-6-1-67

LABOR AND MATERIALS

1	Copper Lead	Connection	1"	\$
1	Curb	Cook Valve T.S. & V.	1 1/4" in.	\$
1	Service box Old returned	Short 3 1/2 x 4 1/2 Long 4 1/2 x 5 1/2		\$
25'	1 1/4" in.	Copper G.I. Curb	Pipe at	\$
	Nipples	in. at		\$
	Bushings	to in. at		\$
	Red'g Inc'g	Coupl'gs to in. at		\$
	Union	in. at		\$
	Meter	in. at		\$
				\$
	Compound Joints	at		\$
	Maintenance Foreman			\$
	Hrs. Water Maint. Man-1	at		\$
	Hrs. Water Maint. Man-2	at		\$
	Hrs. Garage Foreman	at		\$
	Hrs. Labor	at		\$
	Hrs. Compressor	at		\$
				\$
	Trucking			\$
	Pav't Patch			\$
				\$
				\$
				\$
				\$

TO TURN OFF - 5 - 6
 TURNS