


St. Coolidge
 Pl. Ave. No. 52

Name of Owner
Robert La Rose

Labor and Mat'l. Report Dec. 1 1966

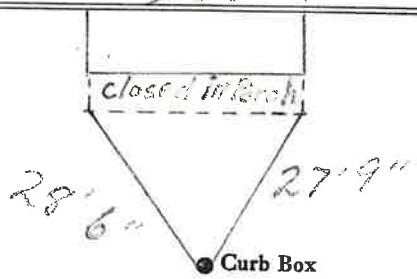

6" Main Elev. of Main at tap 5'
 Gate at ● Gate at ●

● Curb Box

LABOR AND MATERIALS 52

- 1 Copper Lead } Connection 3/4" \$
- 1 Curb } Cock Valve } 3/4 in. \$
- } T.S. & V. }
- 1 Service box } Short 3 1/2 x 4 1/2 } \$
- Old returned } Long 4 1/2 x 5 1/2 } \$
- } Buff or Rdway }
- 8 Ft. 3/4 in. } Copper } Pipe at \$
- } G.I. }
- } C.I. }
- Nipples in. at \$
- Bushings to in. at \$
- Red'g } Inc'g } Coupl'gs. to in. at \$
- Union in. at \$
- Meter in. at \$
- Lead Joints at \$
- Compound Joints at \$
- Maintenance Foreman \$
- Hrs. Water Maint. Man-1 at \$
- Hrs. Water Maint. Man-2 at \$
- Hrs. Garage Foreman at \$
- Hrs. Labor at \$
- Hrs. Compressor at \$
- Compensation Ins. at \$ per C. \$
- Trucking \$
- Pav't Patch \$
- Tap by Gifford & Co. \$
- 12-1-66. \$
- O'head \$