


COOLIDGE

Ave. No. 53

Name of Owner

Labor and Mat'l. Report

AUG 1 1923

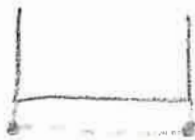

31'7" 20'4" ● Curb Box

6" Main

Elev. of Main at tap 4'

Gate at ●

● Gate at

TAX ID # 302.15-10-17

● Curb Box

LABOR AND MATERIALS

1	Copper Lead	Connection	1/2"	\$
1	Curb	Cock Valve T.S. & V.	3/4 in.	\$
1	Service box Old returned	Short 3 1/2 x 4 1/2 Long 4 1/2 x 5 1/2		\$
43	Ft.	3/4 in. { Copper G. I. Cast	Pipe at	\$
	Nipples	in. at		\$
	Bushings	to in. at		\$
	Red'g Inc'g	Coupl'gs to in. at		\$
	Union	in. at		\$
	Meter	in. at		\$
	Compound Joints	at		\$
	Maintenance Foreman			\$
	Hrs. Water Maint. Man-1	at		\$
	Hrs. Water Maint. Man-2	at		\$
	Hrs. Garage Foreman	at		\$
	Hrs. Labor	at		\$
	Hrs. Compressor	at		\$
	Trucking			\$
	Pav't Patch			\$
				\$
				\$
