

### LABOR AND MATERIALS


1	Copper Lead	} Connection	3/4		\$
1	Curb	} Cock Valve	3/4 in.		\$
		T.S. & V.			
1	Service box Old returned	{ Short 3 1/2 x 4 1/2 Long 4 1/2 x 5 1/2 }			\$
11	Ft.	3/4 in. { Copper G.I. G.I. }	Pipe at		\$
	Nipples	in. at			\$
	Bushings	to in. at			\$
	Red'g Inc'g } Coupl'gs	to in. at			\$
	Union	in. at			\$
	Meter	in. at			\$
					\$
	Compound Joints	at			\$
	Maintenance Foreman				\$
	Hrs. Water Maint. Man—1	at			\$
	Hrs. Water Maint. Man—2	at			\$
	Hrs. Garage Foreman	at			\$
	Hrs. Labor—	at			\$
	Hrs. Compressor	at			\$
					\$
	Trucking				\$
	Pav't Patch				\$
					\$
					\$
St. \_\_\_\_\_  
Pl. \_\_\_\_\_  
Ave. No. 5

COOLIDGE

Name of Owner \_\_\_\_\_  
\_\_\_\_\_

Labor and Mat'l. Report JULY 18 1935

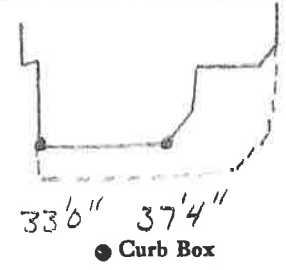

6" Main Elev. of  
Main at tap 5'

Gate at ● ● Gate at

● Curb Box

OLD TAP SHUT OFF AT MAIN