


44-54

St. _____
Pl. _____
Ave. No. 80
Coolidge
Name of Owner

McGinley

Labor and Mat'l. Report July 7 1954

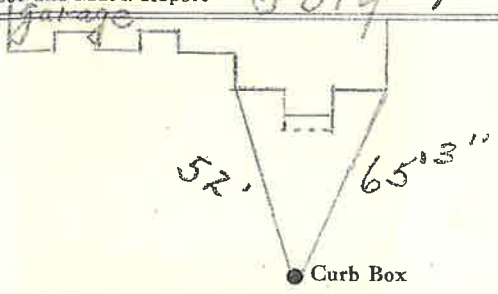

6" Main Elev. of Main at tap 5'

Gate at • Gate at •
Curb Box

LABOR AND MATERIALS 80

1	Copper Lead	Connection	3/4"	\$ 2.41
1	Curb	Cock Valve T.S. & V.	3/4" in.	\$ 3.41
1	Service box	Short 3 1/2 x 4 1/2	}	\$ 4.18
	Old returned	Long 4 1/2 x 5 1/2		
7	Ft.	3/4" in. { Copper G.I. } Pipe at	40	\$ 2.80
	Nipples	in. at		\$
	Bushings	to in. at		\$
	Red'g Inc'g	Coupl'gs to in. at		\$
	Union	in. at		\$
	Meter	in. at		\$
	Lead Joints	at		\$
	Compound Joints	at		\$
	Maintenance Foreman			\$
	Hrs. Water Maint. Man	1 at		\$
8	Hrs. Water Maint. Man	2 at	1.24	\$ 9.92
	Hrs. Garage Foreman	at		\$
9	Hrs. Labor	at	1.13	\$ 10.17
	Hrs. Compressor	at		\$
	Compensation Ins.	at \$ 3.861 per C.		\$ 7.8
	Trucking			\$ 1.50
	Pay't Patch			\$ 12.15
	O'head			\$

Tap by Gifford 7-7-54

35.11

\$ 47.32