


LABOR AND MATERIALS

1 Copper } Connection $\frac{3}{4}$ " \$ _____
 Lead- }
 1 Curb } Cock } $\frac{3}{4}$ in. or iscal \$ _____
 } Valve }
 } T.S. & V. }
 Service box { Short $3\frac{1}{2}$ x $4\frac{1}{2}$ }
 Old returned { Long $4\frac{1}{2}$ x $5\frac{1}{2}$ } \$ _____
 } Buff or Rdway }
 14 Ft. $\frac{3}{4}$ in. { Copper } Pipe at \$ _____
 } G.I. }
 } E.I. }
 Nipples in. at \$ _____
 Bushings to in. at \$ _____
 Red'g }
 Inc'g } Coupl'gs to in. at \$ _____
 Union in. at \$ _____
 Meter in. at \$ _____
 Lead Joints at \$ _____
 Compound Joints at \$ _____
 Maintenance Foreman \$ _____
 Hrs. Water Maint. Man—1 at \$ _____
 Hrs. Water Maint. Man—2 at \$ _____
 Hrs. Garage Foreman at \$ _____
 Hrs. Labor— at \$ _____
 Hrs. Compressor at \$ _____
 Compensation Ins. at \$ _____ per C \$ _____
 Trucking \$ _____
 Pav't Patch \$ _____
 \$ _____
 \$ _____
 \$ _____
 \$ _____
 O'head \$ _____
 \$ _____

Cooper St. Ave. No. 28

Name of Owner William Casey.
 Casey's Hotel.

Labor and Mat'l. Report Dec. 26 1963

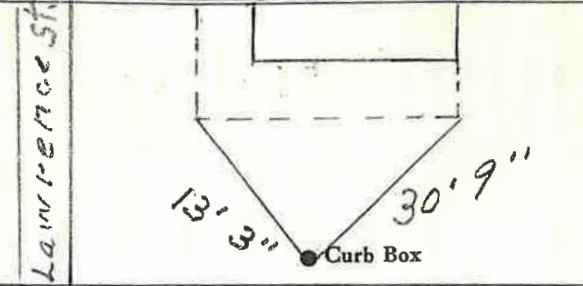

6' Main Elev. of Main at tap 6'

Gate at • Gate at

TAX ID # 303.17-3-1

• Curb Box

This Tap on Cooper St.