


LABOR AND MATERIALS

1	Copper Lead	Connection	1/4"	\$
1	Curb	Cock Valve T.S. & V.	1/4" oriseal	\$
1	Service box	Short 3 1/2 x 4 1/2	5'01-iseal Box	\$
1	Old returned	Long 4 1/2 x 5 1/2		
11	Ft. 1/4 in.	Copper Pipe at		\$
	Nipples	in. at		\$
	Bushings	to in. at		\$
	Red'g Inc'g	Coupl'gs to in. at		\$
	Union	in. at		\$
	Meter	in. at		\$
	Lead Joints	at		\$
	Compound Joints	at		\$
	Maintenance Foreman			\$
	Hrs. Water Maint. Man-1	at		\$
	Hrs. Water Maint. Man-2	at		\$
	Hrs. Garage Foreman	at		\$
	Hrs. Labor	at		\$
	Hrs. Compressor	at		\$
	Compensation Ins.	at \$ per C		\$
	Trucking			\$
	Pav't Patch			\$
	Tap by Kelly + Co.			\$
				\$
	O'head			\$

RAZED 1997

Cooper
 St. Pl. Ave. No. 52
 Name of Owner
 H. H. Hilton Co. Inc.

Labor and Mat'l. Report JUNE 23 1964

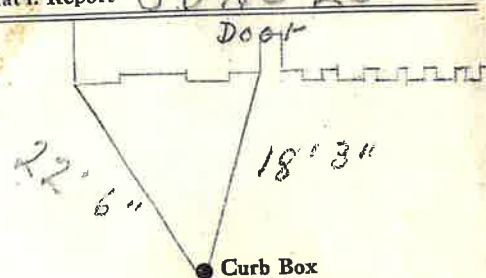

4" Main Elev. of Main at tap 5'
 Gate at • Gate at

• Curb Box