


LABOR AND MATERIALS

1	Copper	} Connection <u>3/4</u>	\$
	Lead		
1	Curb	} <u>3/4</u> in.	\$
	Cock Valve		
	T.S. & V.		
1	Service box	} Short <u>3 1/2</u> x <u>4 1/2</u>	\$
	Old returned		
25	Ft.	} <u>3/4</u> in. Copper	\$
		G.I.	
		} Pipe at	\$
	Nipples	in. at	\$
	Bushings	to in. at	\$
	Red'g	} Coupl'gs to in. at	\$
	Inc'g		
	Union	in. at	\$
	Meter	in. at	\$
			\$
	Compound Joints	at	\$
	Maintenance Foreman		\$
	Hrs. Water Maint. Man-1	at	\$
	Hrs. Water Maint. Man-2	at	\$
	Hrs. Garage Foreman	at	\$
	Hrs. Labor	at	\$
	Hrs. Compressor	at	\$
			\$
	Trucking		\$
	Pav't Patch		\$
			\$
			\$
			\$
			\$

St. COOPER
 Ave. No. 59

Name of Owner _____

Labor and Mat'l. Report AUG. 16 1933

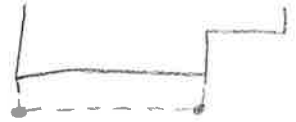

43 1/6" 34 5/8" or 35'
 or 44' ● Curb Box

6" Main Elev. of Main at tap 5 1/2'

Gate at ● ● Gate at

TAX ID # 303.13-19-15

● Curb Box

OLD TAP SHUT OFF TO MAIN