


LABOR AND MATERIALS

1	Copper Lead	Connection	3/4"	\$
1	Curb	Cock Valve T.S. & V.	3/4" in.	\$
1	Service box Old returned	Short 3 1/2 x 4 1/2 Long 4 1/2 x 5 1/2		\$
24	Ft.	3/4 in. { Copper C.I. } Pipe at		\$
	Nipples	in. at		\$
1	Bushings	3/4 to 1/2 in. at		\$
	Red'g Inc'g	Coupl'gs. to in. at		\$
	Union	in. at		\$
	Meter	in. at		\$
	Compound Joints	at		\$
	Maintenance Foreman			\$
	Hrs. Water Maint. Man-1	at		\$
	Hrs. Water Maint. Man-2	at		\$
	Hrs. Garage Foreman	at		\$
	Hrs. Labor	at		\$
	Hrs. Compressor	at		\$
	Trucking			\$
	Pav't Patch			\$
				\$
				\$
St. Pt. Ave. No. 6900
 Name of Owner COOPER
 TAX ID # 303.17-12-5

Labor and Mat'l. Report JULY 7 1926

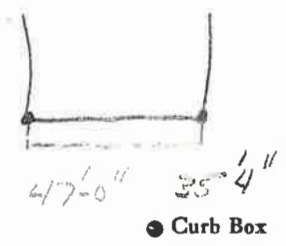

4" Main Elev. of Main at tap 6'
 Gate at ● Gate at ●

● Curb Box

41'6" FROM LEFT SIDE OF PORCH
 27' FROM RIGHT SIDE OF PORCH