


LABOR AND MATERIALS

|    |                       |                          |         |    |
|----|-----------------------|--------------------------|---------|----|
| 1  | Copper Lead           | Connection               | 3/4     | \$ |
| 1  | Curb                  | Cock Valve T.S. & V.     | 3/4 in. | \$ |
|    | Service box           | Short 3 1/2 x 4 1/2      |         | \$ |
|    | Old returned          | Long 4 1/2 x 5 1/2       |         | \$ |
| 13 | Ft.                   | 3/4 in. Copper C.I. C.I. | Pipe at | \$ |
|    | Nipples               | in. at                   |         | \$ |
|    | Bushings              | to in. at                |         | \$ |
|    | Red'g Inc'g           | Coupl'gs to in. at       |         | \$ |
|    | Union                 | in. at                   |         | \$ |
|    | Meter                 | in. at                   |         | \$ |
|    | Compound Joints       | at                       |         | \$ |
|    | Maintenance Foreman   |                          |         | \$ |
|    | Hrs. Water Maint. Man | —1 at                    |         | \$ |
|    | Hrs. Water Maint. Man | —2 at                    |         | \$ |
|    | Hrs. Garage Foreman   | at                       |         | \$ |
|    | Hrs. Labor            | at                       |         | \$ |
|    | Hrs. Compressor       | at                       |         | \$ |
|    | Trucking              |                          |         | \$ |
|    | Pav't Patch           |                          |         | \$ |
|    |                       |                          |         | \$ |
|    |                       |                          |         | \$ |
St. COOPER  
 Ave. No. 88

Name of Owner \_\_\_\_\_

Labor and Mat'l. Report MAY 15 1930

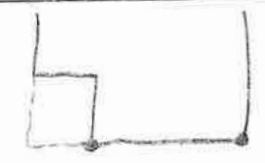

32-4 30-11  
 ● Curb Box

4" Main Elev. of Main at tap 52.1

Gate at ● Gate at ●

TAX ID # 303.13-9-2

● Curb Box

OLD TAP DISCONNECTED