


LABOR AND MATERIALS

1	Copper Lead	} Connection Cock Valve T.S. & V.	3/4	in.	\$
1	Curb				
1	Service box Old returned	} Short 3 1/2 x 4 1/2 Long 4 1/2 x 5 1/2			\$
26	Ft. 3/4 in.				
	Nipples	in. at	\$		
	Bushings	to in. at	\$		
	Red'g Inc'g	} Coupl'gs	to	in. at	\$
	Union				
	Meter	in. at	\$		
	Compound Joints	at	\$		
	Maintenance Foreman		\$		
	Hrs. Water Maint. Man	1 at	\$		
	Hrs. Water Maint. Man	2 at	\$		
	Hrs. Garage Foreman	at	\$		
	Hrs. Labor	at	\$		
	Hrs. Compressor	at	\$		
	Trucking		\$		
	Pav't Patch		\$		
			\$		
			\$		
St. COOPER
~~Pl.~~
 Ave. No. 89
 Name of Owner
 TAX ID # 303.13-10-20

Labor and Mat'l. Report 10-8 1930

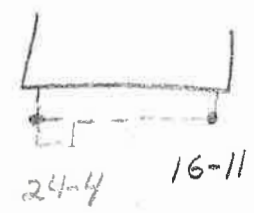

● Curb Box

4" Main Elev. of Main at tap 5 1/2'
 Gate at ● Gate at ●

● Curb Box

OLD TAP DISCONNECTED