


LABOR AND MATERIALS

1	Copper	} Connection	3/4	\$
	Lead			
1	Curb	} Cock Valve T.S. & V. }	3/4 in.	\$
1	Service box	} Short 3 1/2 x 4 1/2 } Long 4 1/2 x 5 1/2 }		\$
	Old returned			
24	3/4 in.	} Copper } C.I. } C.I. }	Pipe at	\$
	Nipples	in. at	\$	
	Bushings	to in. at	\$	
1	Red Ldg	} Coupl'gs BRASS }	to in. at	\$
	Union	in. at	\$	
	Meter	in. at	\$	
			\$	
	Compound Joints	at	\$	
	Maintenance Foreman		\$	
	Hrs. Water Maint. Man-1	at	\$	
	Hrs. Water Maint. Man-2	at	\$	
	Hrs. Garage Foreman	at	\$	
	Hrs. Labor	at	\$	
	Hrs. Compressor	at	\$	
			\$	
	Trucking		\$	
	Pav't Patch		\$	
			\$	
			\$	
St. Cooper
~~Pt.~~
 Ave. No. 93

Name of Owner
 TAX ID # 303.13-10-18

Labor and Mat'l. Report SEPT 21 1967

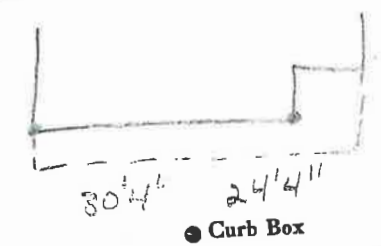

4" Main Elev. of Main at tap 5'

Gate at • Gate at •

• Curb Box

OLD TAP SHUT OFF