


LABOR AND MATERIALS

1	Copper Lead	Connection	3/4"	\$
1	Curb	Cock Valve T.S. & V.	3/4 in.	\$
1	Service box	Short 3 1/2 x 4 1/2		\$
	Old returned	Long 4 1/2 x 5 1/2		\$
24	Ft.	3/4 in. { Copper C.I. C.I. }	Pipe at	\$
	Nipples	in. at		\$
	Bushings	to in. at		\$
1	Red'g In'g	Coupl'gs	BRASS to in. at	\$
	Union	in. at		\$
	Meter	in. at		\$
	Compound Joints	at		\$
	Maintenance Foreman			\$
	Hrs. Water Maint. Man	1 at		\$
	Hrs. Water Maint. Man	2 at		\$
	Hrs. Garage Foreman	at		\$
	Hrs. Labor	at		\$
	Hrs. Compressor	at		\$
	Trucking			\$
	Pav't Patch			\$
				\$
				\$
St. Pt. Ave. No. 97
COOPER

Name of Owner
 TAX ID # 303.13-10-16

Labor and Mat'l. Report AUG 11 1927

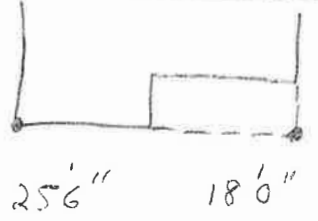

● Curb Box

6" Main Elev. of Main at tap 4 1/2'
 Gate at ● Gate at

● Curb Box