


LABOR AND MATERIALS

Copper	} Connection		\$	
Lead				
Curb	} Cock } Valve } T. S. & V.	in.	\$	
Service box		} Short 3 1/2 x 4 1/2 } Long 4 1/2 x 5 1/2		
Old returned				\$
10 Ft. 1 in.	} Copper } G. I. } C. I.	Pipe at	\$	
Nipples		in. at	\$	
Bushings	to	in. at	\$	
Red'g	} Coupl'gs	to	in. at	
Inc'g				\$
Union	in. at		\$	
Meter	in. at		\$	
Compound Joints	at		\$	
Maintenance Foreman			\$	
Hrs. Water Maint. Man-1	at		\$	
Hrs. Water Maint. Man-2	at		\$	
Hrs. Garage Foreman	at		\$	
Hrs. Labor	at		\$	
Hrs. Compressor	at		\$	
Trucking			\$	
Pav't Patch			\$	
			\$	
			\$	
			\$	
			\$	

St. COOPER
 Pt. 14-16
 Ave. No. 14-16

Name of Owner
ASKCO

Labor and Mat'l. Report 19 22

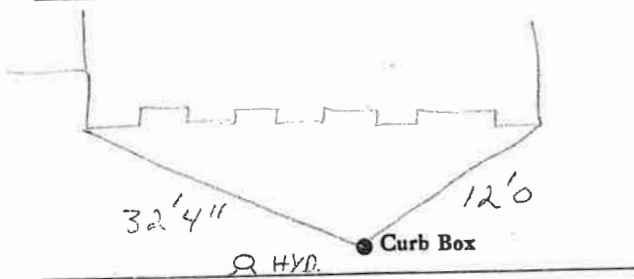

4" Main Elev. of Main at tap 6'

Gate at • Gate at •

#16 TAX ID # 303.17-12-2

This may be the same box as shown on card for 14 Cooper - renewal tape 1981