


LABOR AND MATERIALS

Copper	}	Connection	-----	\$
Lead				
Curb	}	Cock Valve	-----	\$
			T. S. & V.	in. -----
Service Box	}	Short 3 1/2 x 4 1/2	-----	\$
Old returned		Long 4 1/2 x 5 1/2	-----	
		Buff. or Rdway	-----	
	}	Copper	} Pipe at -----	\$
26 Ft. ^{3/4}		Galv Iron		
in.		Cast Iron		
Nipples		in. at -----	\$	
Bushings		to ----- in. at -----	\$	
Red'g	}	Couplings	-----	\$
Inc'g			to ----- in. at -----	
Union		in. at -----	\$	
Meter		in. at -----	\$	
Lead Joints		at -----	\$	
Leadite Joints		at -----	\$	
Hrs. Foreman		at -----	\$	
Hrs. Chauffeur		at -----	\$	
Hrs. Tapper		at -----	\$	
Hrs. Labor		at -----	\$	
Hrs. Labor		at -----	\$	
Hrs. Compressor		at -----	\$	
Compensation Ins.		-----	\$	
Trucking		-----	\$	
Builders Use of Water		-----	\$	
		-----	\$	
		-----	\$	
		-----	\$	

St. 101
 Pt. 77
 Ave. No. 77

Name of Owner
Palunci

Labor and Mat'l. Report May 13 1936

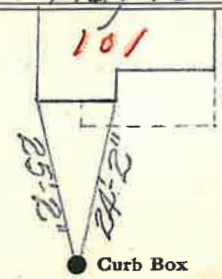

4" Main Elev. of Main at tap 5'

Gate at ● ● Gate at

TAX ID # 303.3-10-14

● Curb Box