


LABOR AND MATERIALS

Copper } Connection		\$
Lead } T. S. & V.		\$
Curb } Cock Valve	in.	\$
		\$
Service box } Short 3½ x 4½		\$
Old returned } Long 4½ x 5½		
12 Ft. ¾ in. } Copper	Pipe at	\$
		\$
Nipples	in. at	\$
Bushings	to in. at	\$
Red'g } Coupl'gs	to in. at	\$
Inc'g }		\$
Union	in. at	\$
Meter	in. at	\$
		\$
Compound Joints	at	\$
Maintenance Foreman		\$
Hrs. Water Maint. Man-1	at	\$
Hrs. Water Maint. Man-2	at	\$
Hrs. Garage Foreman	at	\$
Hrs. Labor	at	\$
Hrs. Compressor	at	\$
		\$
Trucking		\$
Pav't Patch		\$
		\$
		\$
		\$
		\$

St. Cooper
 Ave. No. 102

Name of Owner
 TAX ID # 303.13-9-9

Labor and Mat'l. Report 1978

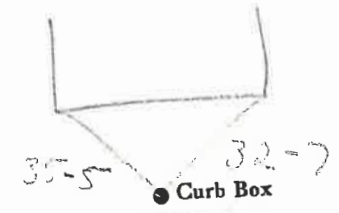

4/11 Main Elev. of Main at tap
 Gate at • Gate at

• Curb Box

RENEWAL TAP - 1998