


LABOR AND MATERIALS

1	Copper Lead	} Connection		\$
1	Curb			\$
		} Cock Valve T.S.&V.	in.	\$
1	Service box Old returned		} Short 3 1/2 x 4 1/2 Long 4 1/2 x 5 1/2	
26	Ft. 3/4 in.	} Copper G.I. G.I.		Pipe at
	Nipples		in. at	\$
	Bushings	to	in. at	\$
	Red'g Inc'g	} Coupl'gs	to	in. at
	Union		in. at	\$
	Meter	in. at	\$	
	Compound Joints at		\$	
	Maintenance Foreman		\$	
	Hrs. Water Maint. Man-1 at		\$	
	Hrs. Water Maint. Man-2 at		\$	
	Hrs. Garage Foreman	at	\$	
	Hrs. Labor	at	\$	
	Hrs. Compressor at		\$	
	Trucking		\$	
	Pav't Patch		\$	
			\$	
			\$	
St. COOPER
~~Pt.~~
 Ave. No. 113

Name of Owner _____

Labor and Mat'l. Report AUG 27 19 34

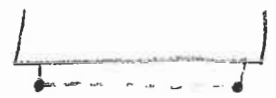

24-11 29-8

● Curb Box

6" Main Elev. of Main at tap 4 1/2'

Gate at ● ● Gate at

TAX ID # 303.13-4-11

● Curb Box

OLD TAP SHUT OFF AT MAIN

OUTSIDE CLEANOUT - 6" NORTH OF CURB BOX