

LABOR AND MATERIALS

1	Copper Lead	Connection	3/4"	\$	2.41
1	Curb	Cock Valve T.S. & V.	3/4 in.	\$	3.41
1	Service box	Short 3 1/2 x 4 1/2		\$	4.18
	Old returned	Long 4 1/2 x 5 1/2		\$	
		Buff or Rdway		\$	
12	Ft. 3/4 in.	Copper G.I. C.I.	Pipe at 40	\$	4.80
	Nipples	in. at		\$	
	Bushings	to in. at		\$	
	Red'g Inc'g	Coupl'gs	to in. at	\$	
	Union	in. at		\$	
	Meter	in. at		\$	
	Lead Joints	at		\$	
	Compound Joints	at		\$	
	Maintenance Foreman			\$	
	Hrs. Water Maint. Man-1	at		\$	
3	Hrs. Water Maint. Man-2	at 1.24		\$	3.72
	Hrs. Garage Foreman	at		\$	
7	Hrs. Labor	at 1.13		\$	7.91
	Hrs. Compressor	at		\$	
	Compensation Ins.	at \$3.961 per C		\$	45
	Trucking			\$	1.50
	Pay't Patch			\$	13.50
	Tap by Gissard	9-9-54		\$	
	O'head			\$	
				\$	41.98


2838

63-54

St. Cooper Ave. No. 114

Name of Owner Annesty

Labor and Mat'l. Report Sept. 9 19 54

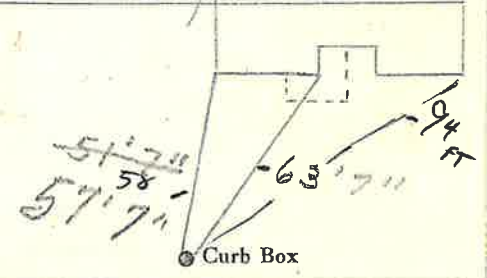

6" Main Elev. of Main at tap 4 1/2'

Gate at • • Gate at

TAX ID # 303.13-3-2

• Curb Box