

## LABOR AND MATERIALS

1. Copper Lead Connection $\frac{3}{4}$ .....	\$ 2.87
1. Curb Cock Valve T. S. & V. } $\frac{3}{4}$ in.....	\$ 3.62
1. Service box Old returned { Short $3\frac{1}{2} \times 4\frac{1}{2}$ Long $4\frac{1}{2} \times 5\frac{1}{2}$ Buff or Rdway }.....	\$ 4.68
18. Ft. $\frac{3}{4}$ in. { Copper G.I. } Pipe at 32.....	\$ 5.76
..... Nipples..... in. at.....	\$ .....
..... Bushings..... to..... in. at.....	\$ .....
..... Red'g / Inc'g Coupl'gs..... to..... in. at.....	\$ .....
..... Union..... in. at.....	\$ .....
..... Meter..... in. at.....	\$ .....
1. Lead Joints at $\frac{3}{4}$ Adapter.....	\$ 35
..... Compound Joints at Male.....	\$ .....
5. Hrs. Water Maint. Man-1 at.....	\$ .....
5. Hrs. Water Maint. Man-2 at ..10.2.....	\$ 5.10
1.1 Hrs. Labor..... at.....	\$ 10.01
..... Hrs. Labor..... at.....	\$ .....
..... Hrs. Compressor at.....	\$ .....
..... Compensation Ins. at \$2.18 per C.....	\$ 33
..... Trucking.....	\$ 2.00
..... Pav't Patch.....	\$ 10.25
..... Top by [unclear].....	\$ .....
..... O'head.....	\$ .....
\$ 44.97	


41

St.   
 Pl.   
 Ave. No. 121

Cooper

Name of Owner Hinstrank

Labor and Mat'l. Report June 1 1949

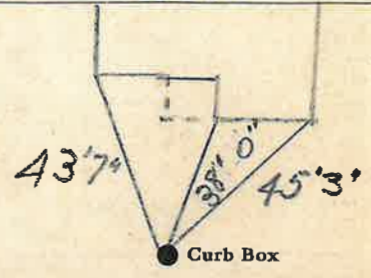

6" Main

Elev. of Main at tap 5'

Gate at ● ● Gate at

TAX ID # 303.13-4-8

● Curb Box